




油尖旺區議會交通運輸委員會會議

運輸署 / 路政署過去兩個月內完成、正在施工或規劃中的區域交通改善工程項目及時間表 (截至 2024 年 2 月 28 日)

項目	地點	擬建的交通改善工程項目	動工日期	完工日期	詳細備註	運輸署工程師 姓名(電話)	路政署工程師 姓名(電話)
1	埃華街近櫟樹街	擬加裝護柱及欄杆 (圖則編號: No. K230541.01)	2024年1月	2024年1月	工程已於1月下旬完成。	江逸輝先生 (2399 2509)	葉沛林先生 (2707 7418)
2	海庭道近海泓道	擬加裝交通標誌 (圖則編號: No. K231123.01)	2024年1月	2024年1月	工程已於1月上旬完成。	何文軒先生 (2399 2506)	胡濤男先生 (2707 7253)
3	加士居道近佐敦道	擬拆除臨時方向標誌 (圖則編號: K231223.01)	2024年1月	2024年1月	工程已於1月下旬完成。	同上	同上
4	柯士甸道西近戲曲中心	擬更換交通標誌 (圖則編號: K220498.01)	2024年1月	2024年1月	工程已於1月中旬完成。	同上	同上
5	加連威老道26-32號	擬更換交通標誌 (圖則編號: K220530.01A)	2024年1月	2024年1月	工程已於1月下旬完成。	陳君諾先生 (2399 2511)	同上

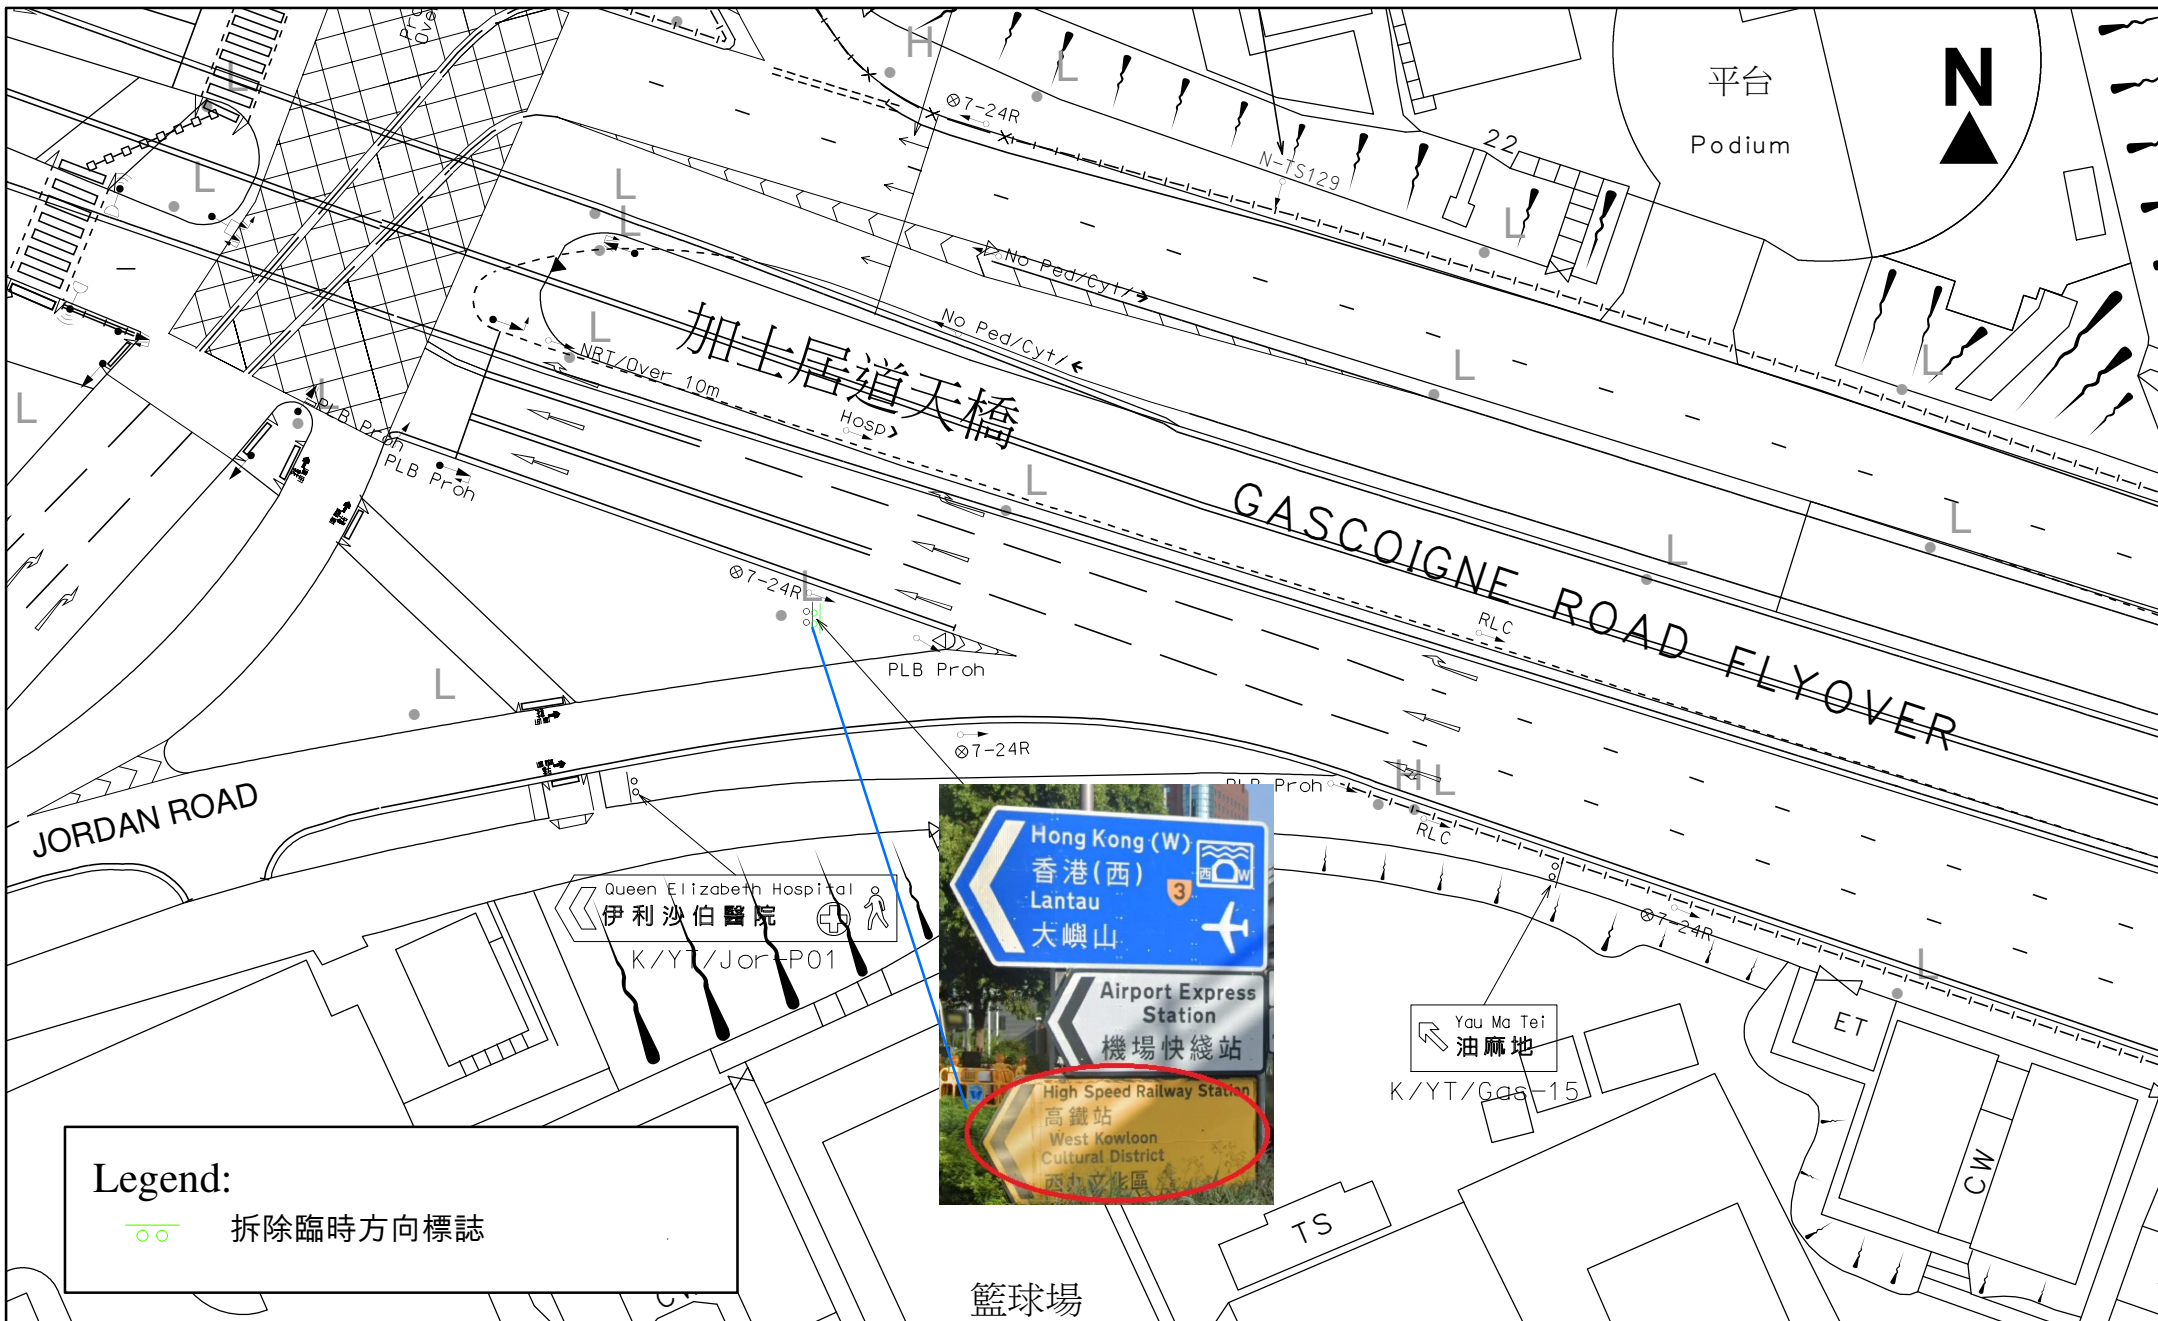

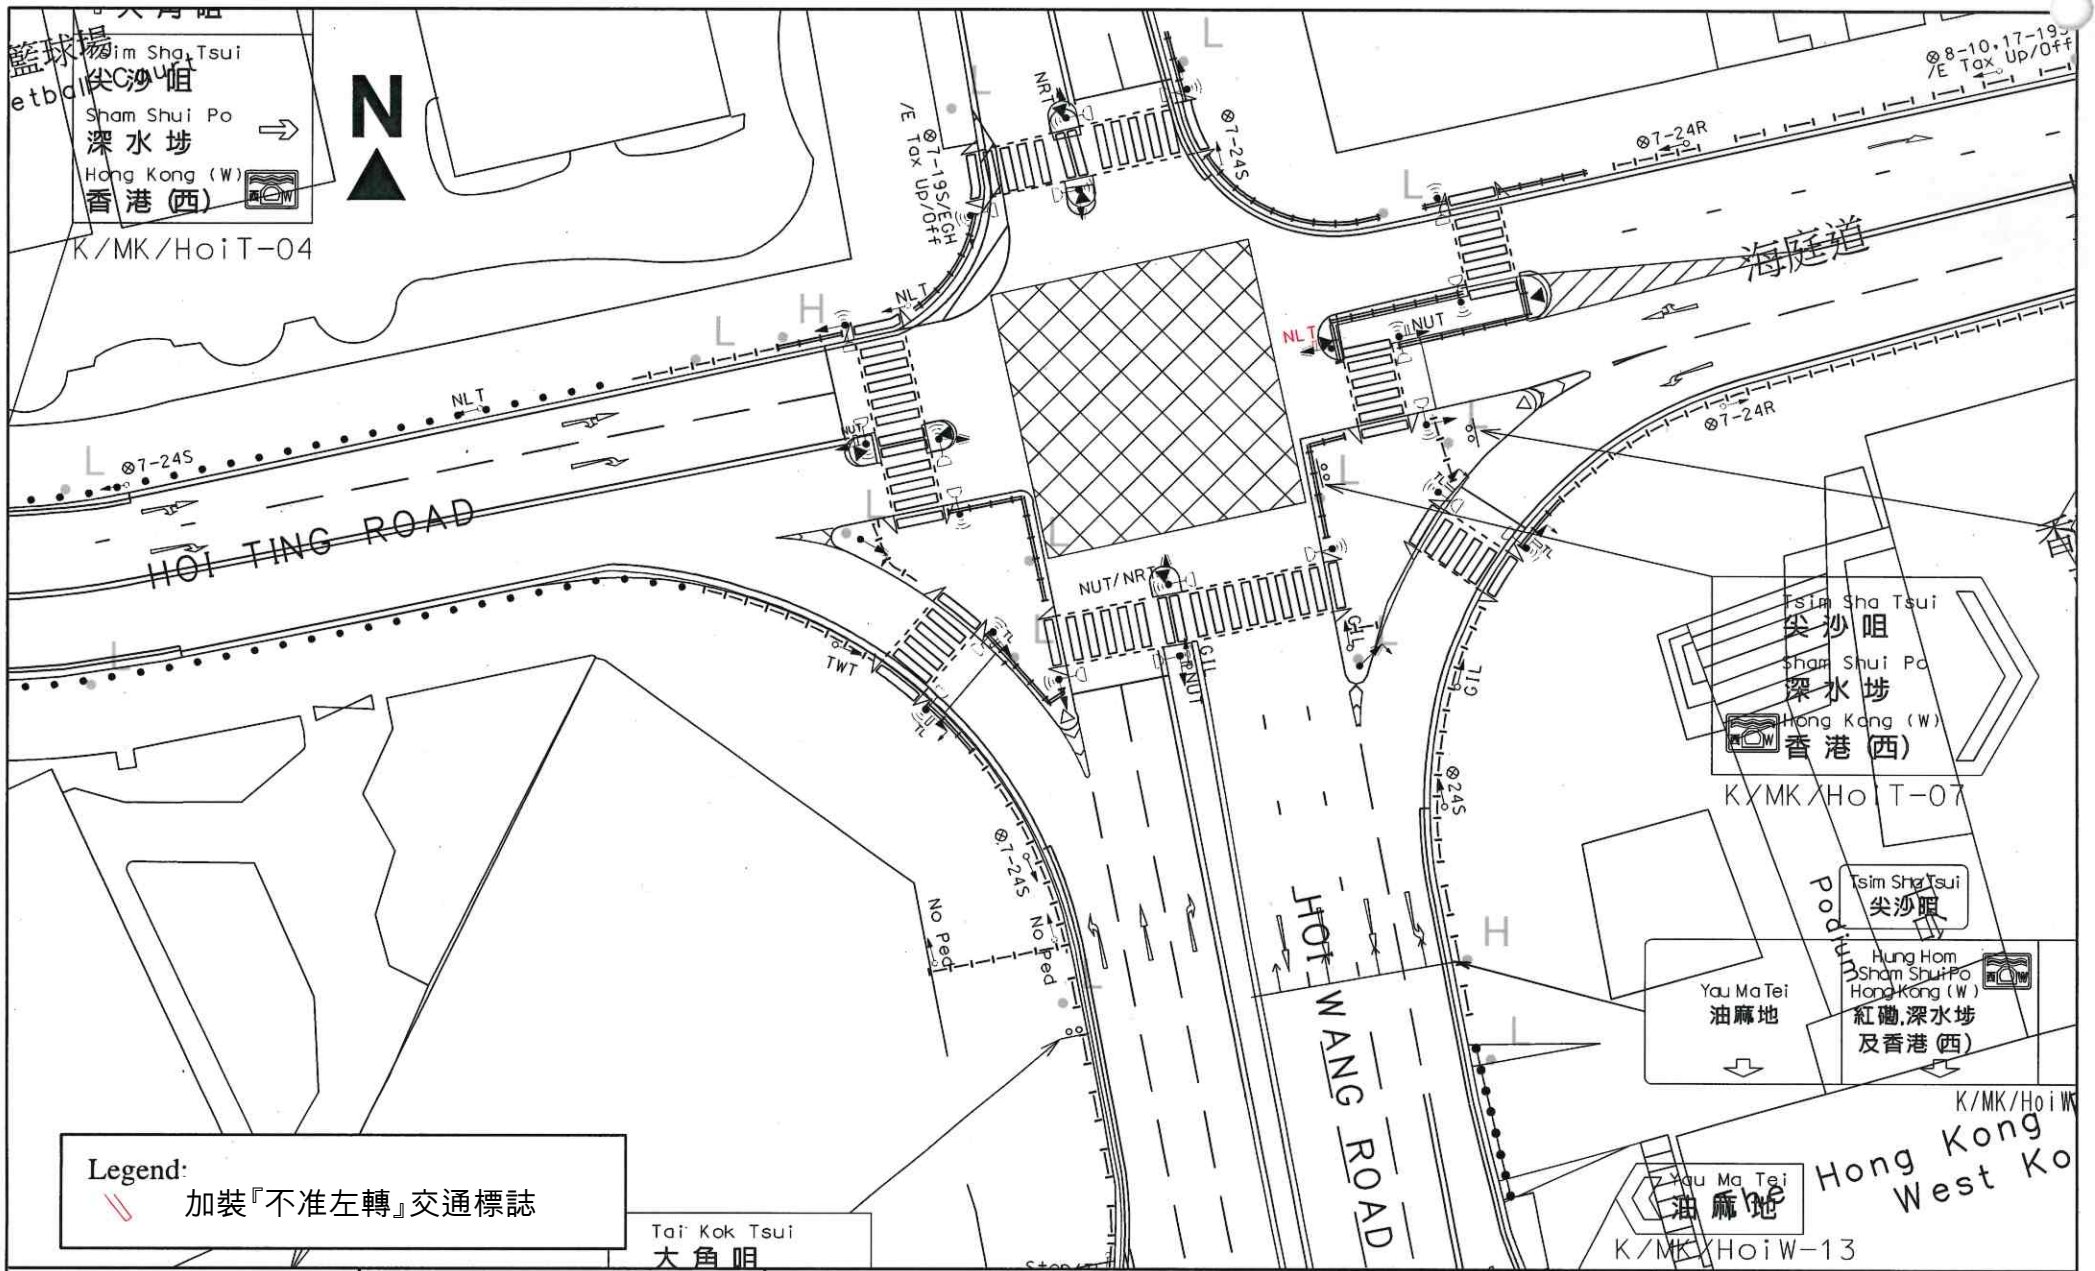

Legend:
 加裝『不准左轉』交通標誌


Tai Kok Tsui
 大角咀

Tsim Sha Tsui
 尖沙咀
 Sham Shui Po
 深水埗
 Hong Kong (W)
 香港(西)

Yau Ma Tei
 油麻地

Hong Kong
 West Kowloon


 運輸署 <i>Transport Department</i>	TRAFFIC ENGINEERING (KLN.) DIV.	Location: Hoi Ting Road near Hoi Wang Road			WRF.NO. WR/HY/TE/KL/23/0
		Survey Sheet No. K11P19C	Scale: 1:500 (A4)	Drawing No. K231123.01	Date: 11.09.2023

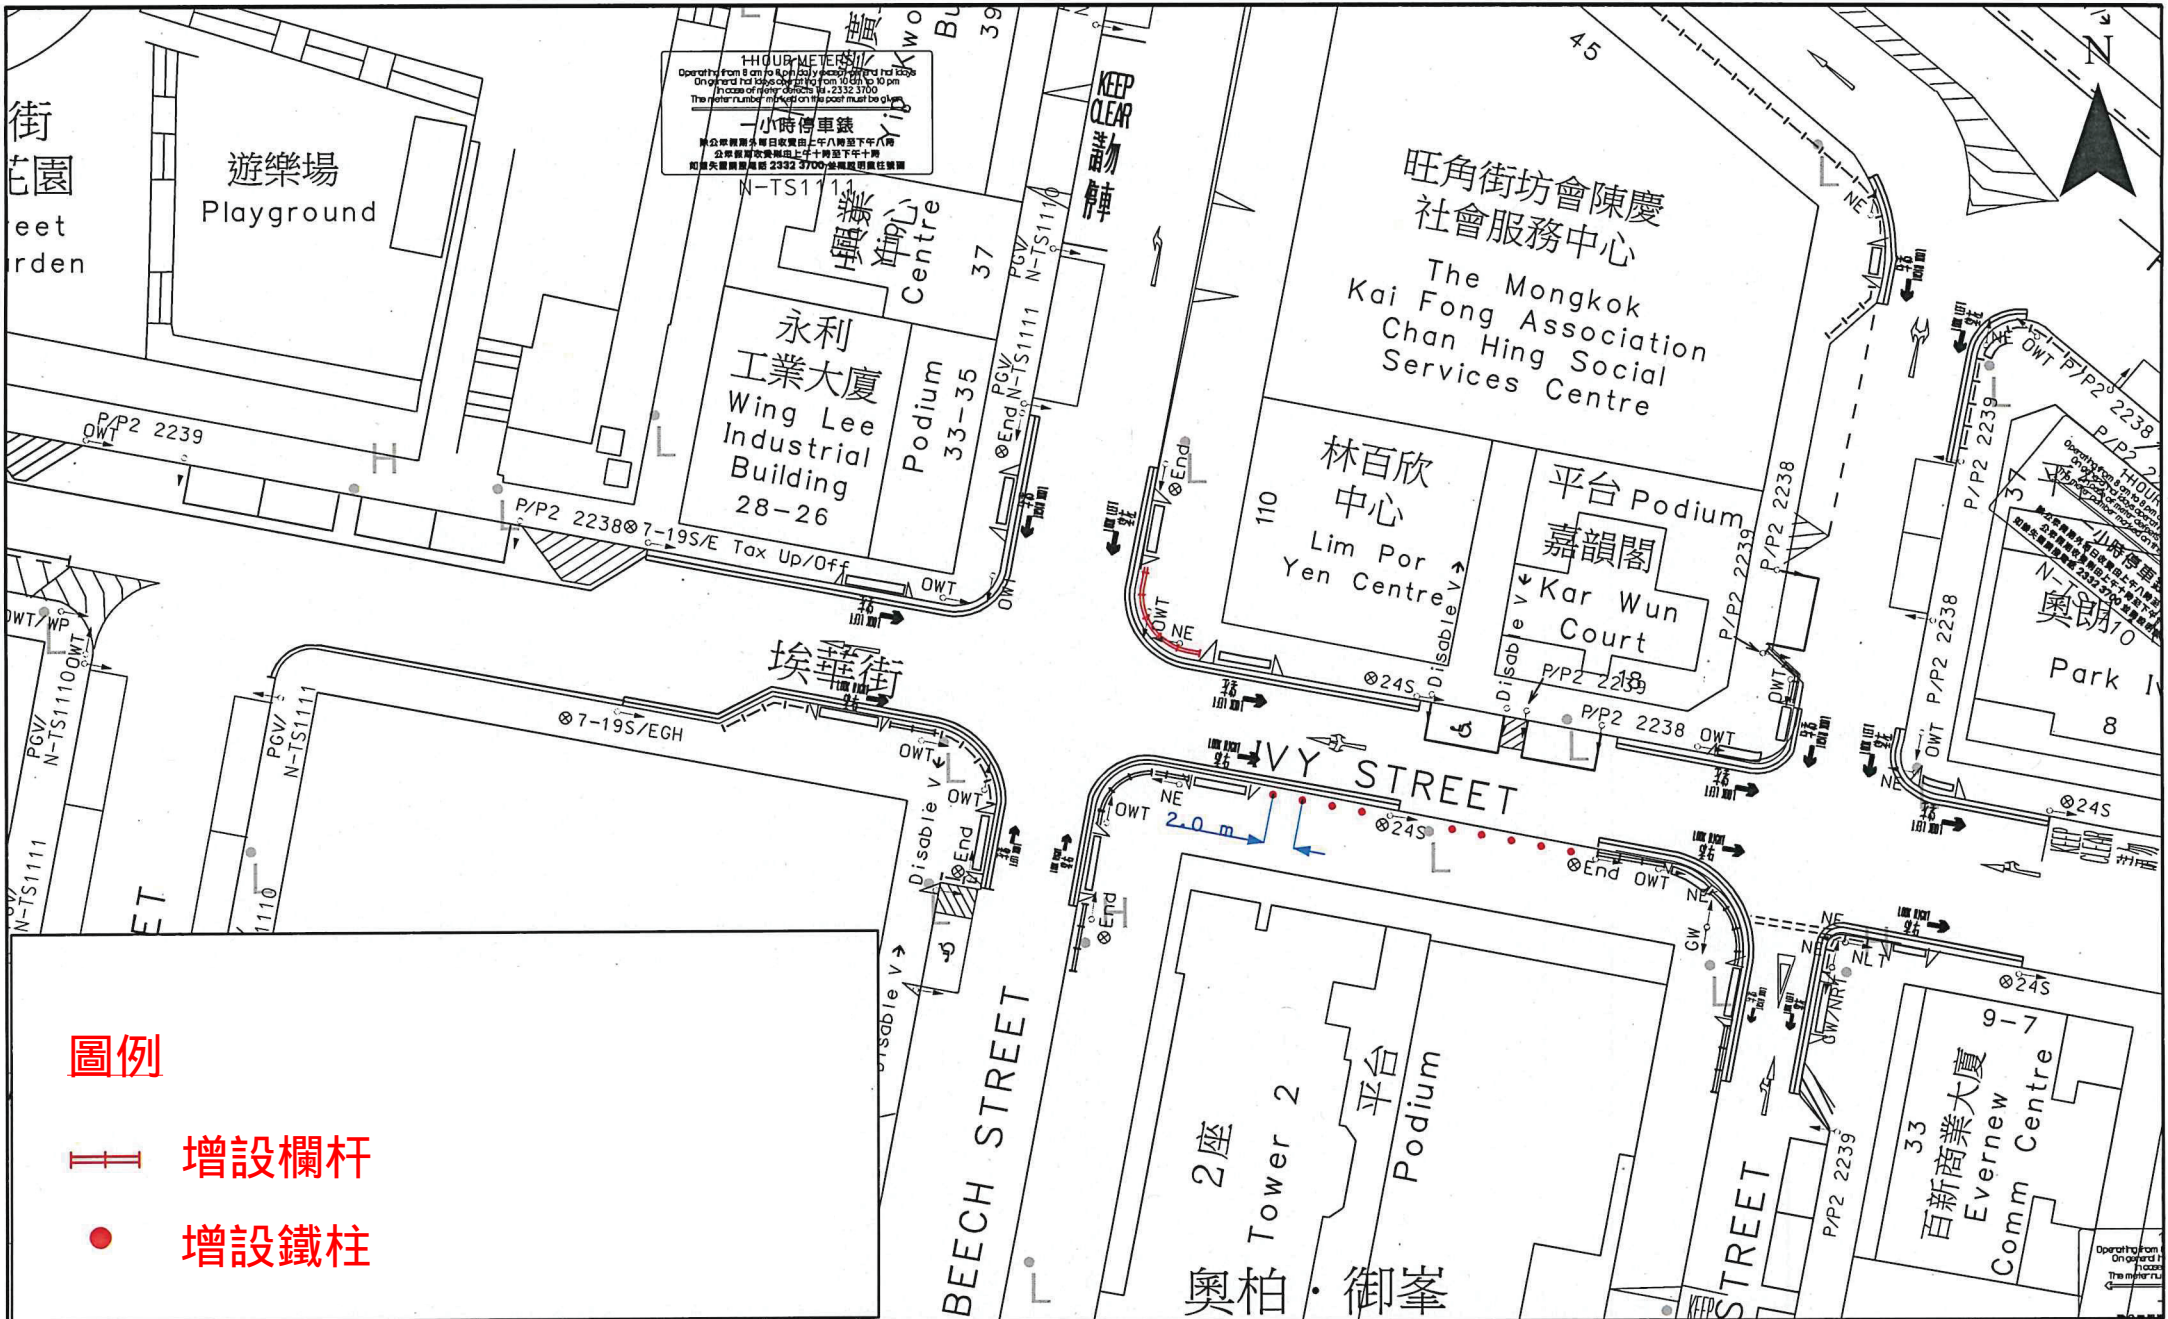

HOUR METERS
 Operating from 8 am to 8 pm daily except on public holidays
 Original and 1st copy operating from 10:30 to 10 pm
 In case of injury, contact Tel. 2332 3700
 The reference number kept on the post must be kept
 一小時停車錶
 辦公時間：每日由上午八時至下午八時
 公眾假期及假期由上午十時至下午十時
 如無先期通知，電話 2332 3700 查詢詳情或前往辦事處

圖例

-  新增欄杆
-  新增鐵柱

 運輸署 Transport Department	TRAFFIC ENGINEERING (KLN.) DIV.	LOCATION: IVY STREET / BEECH STREET		WRF NO. : WR/HY/TE/KL/23/01134	
		SURVEY SHEET NO. : K11P19A	SCALE: 1:500 (A4)	DRAWING NO. : K230541.01	DATE: 17.05.2023




金巴利街
KIMBERLEY STREET

圖例：



擬更換交通標誌


(貨車夜泊時間由原來"下午9時至上午7時"改至"下午8時至上午7時")

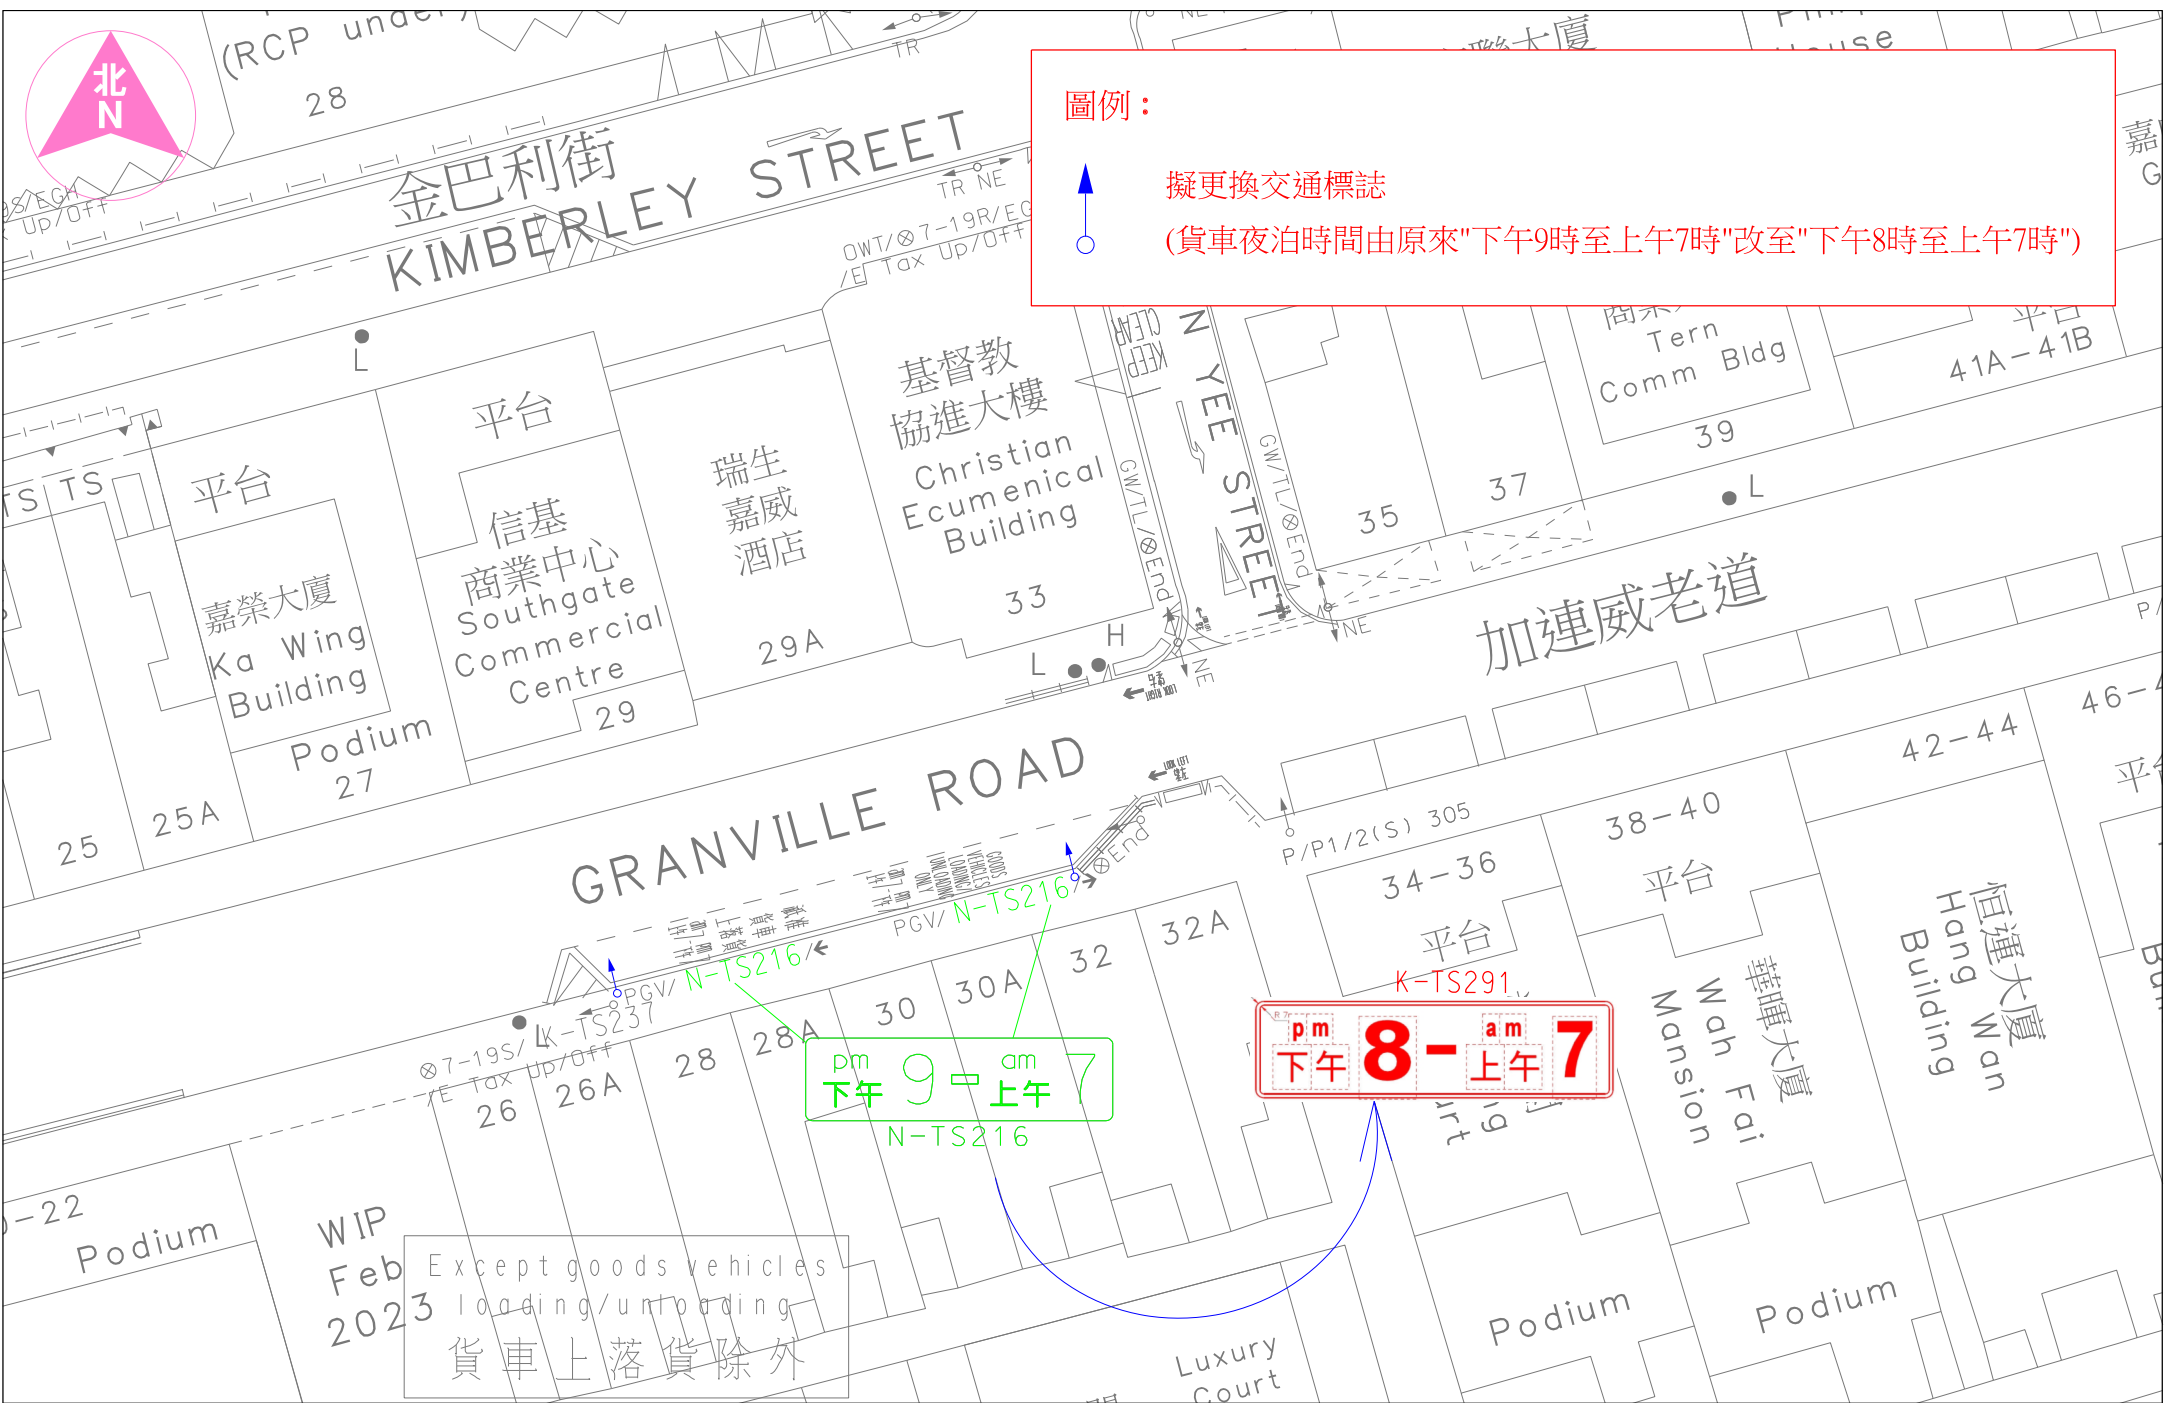

pm 9 - am 7
下午 9 - 上午 7
N-TS216

pm 8 - am 7
下午 8 - 上午 7
K-TS291

Except goods vehicles loading/unloading
貨車上落貨除外

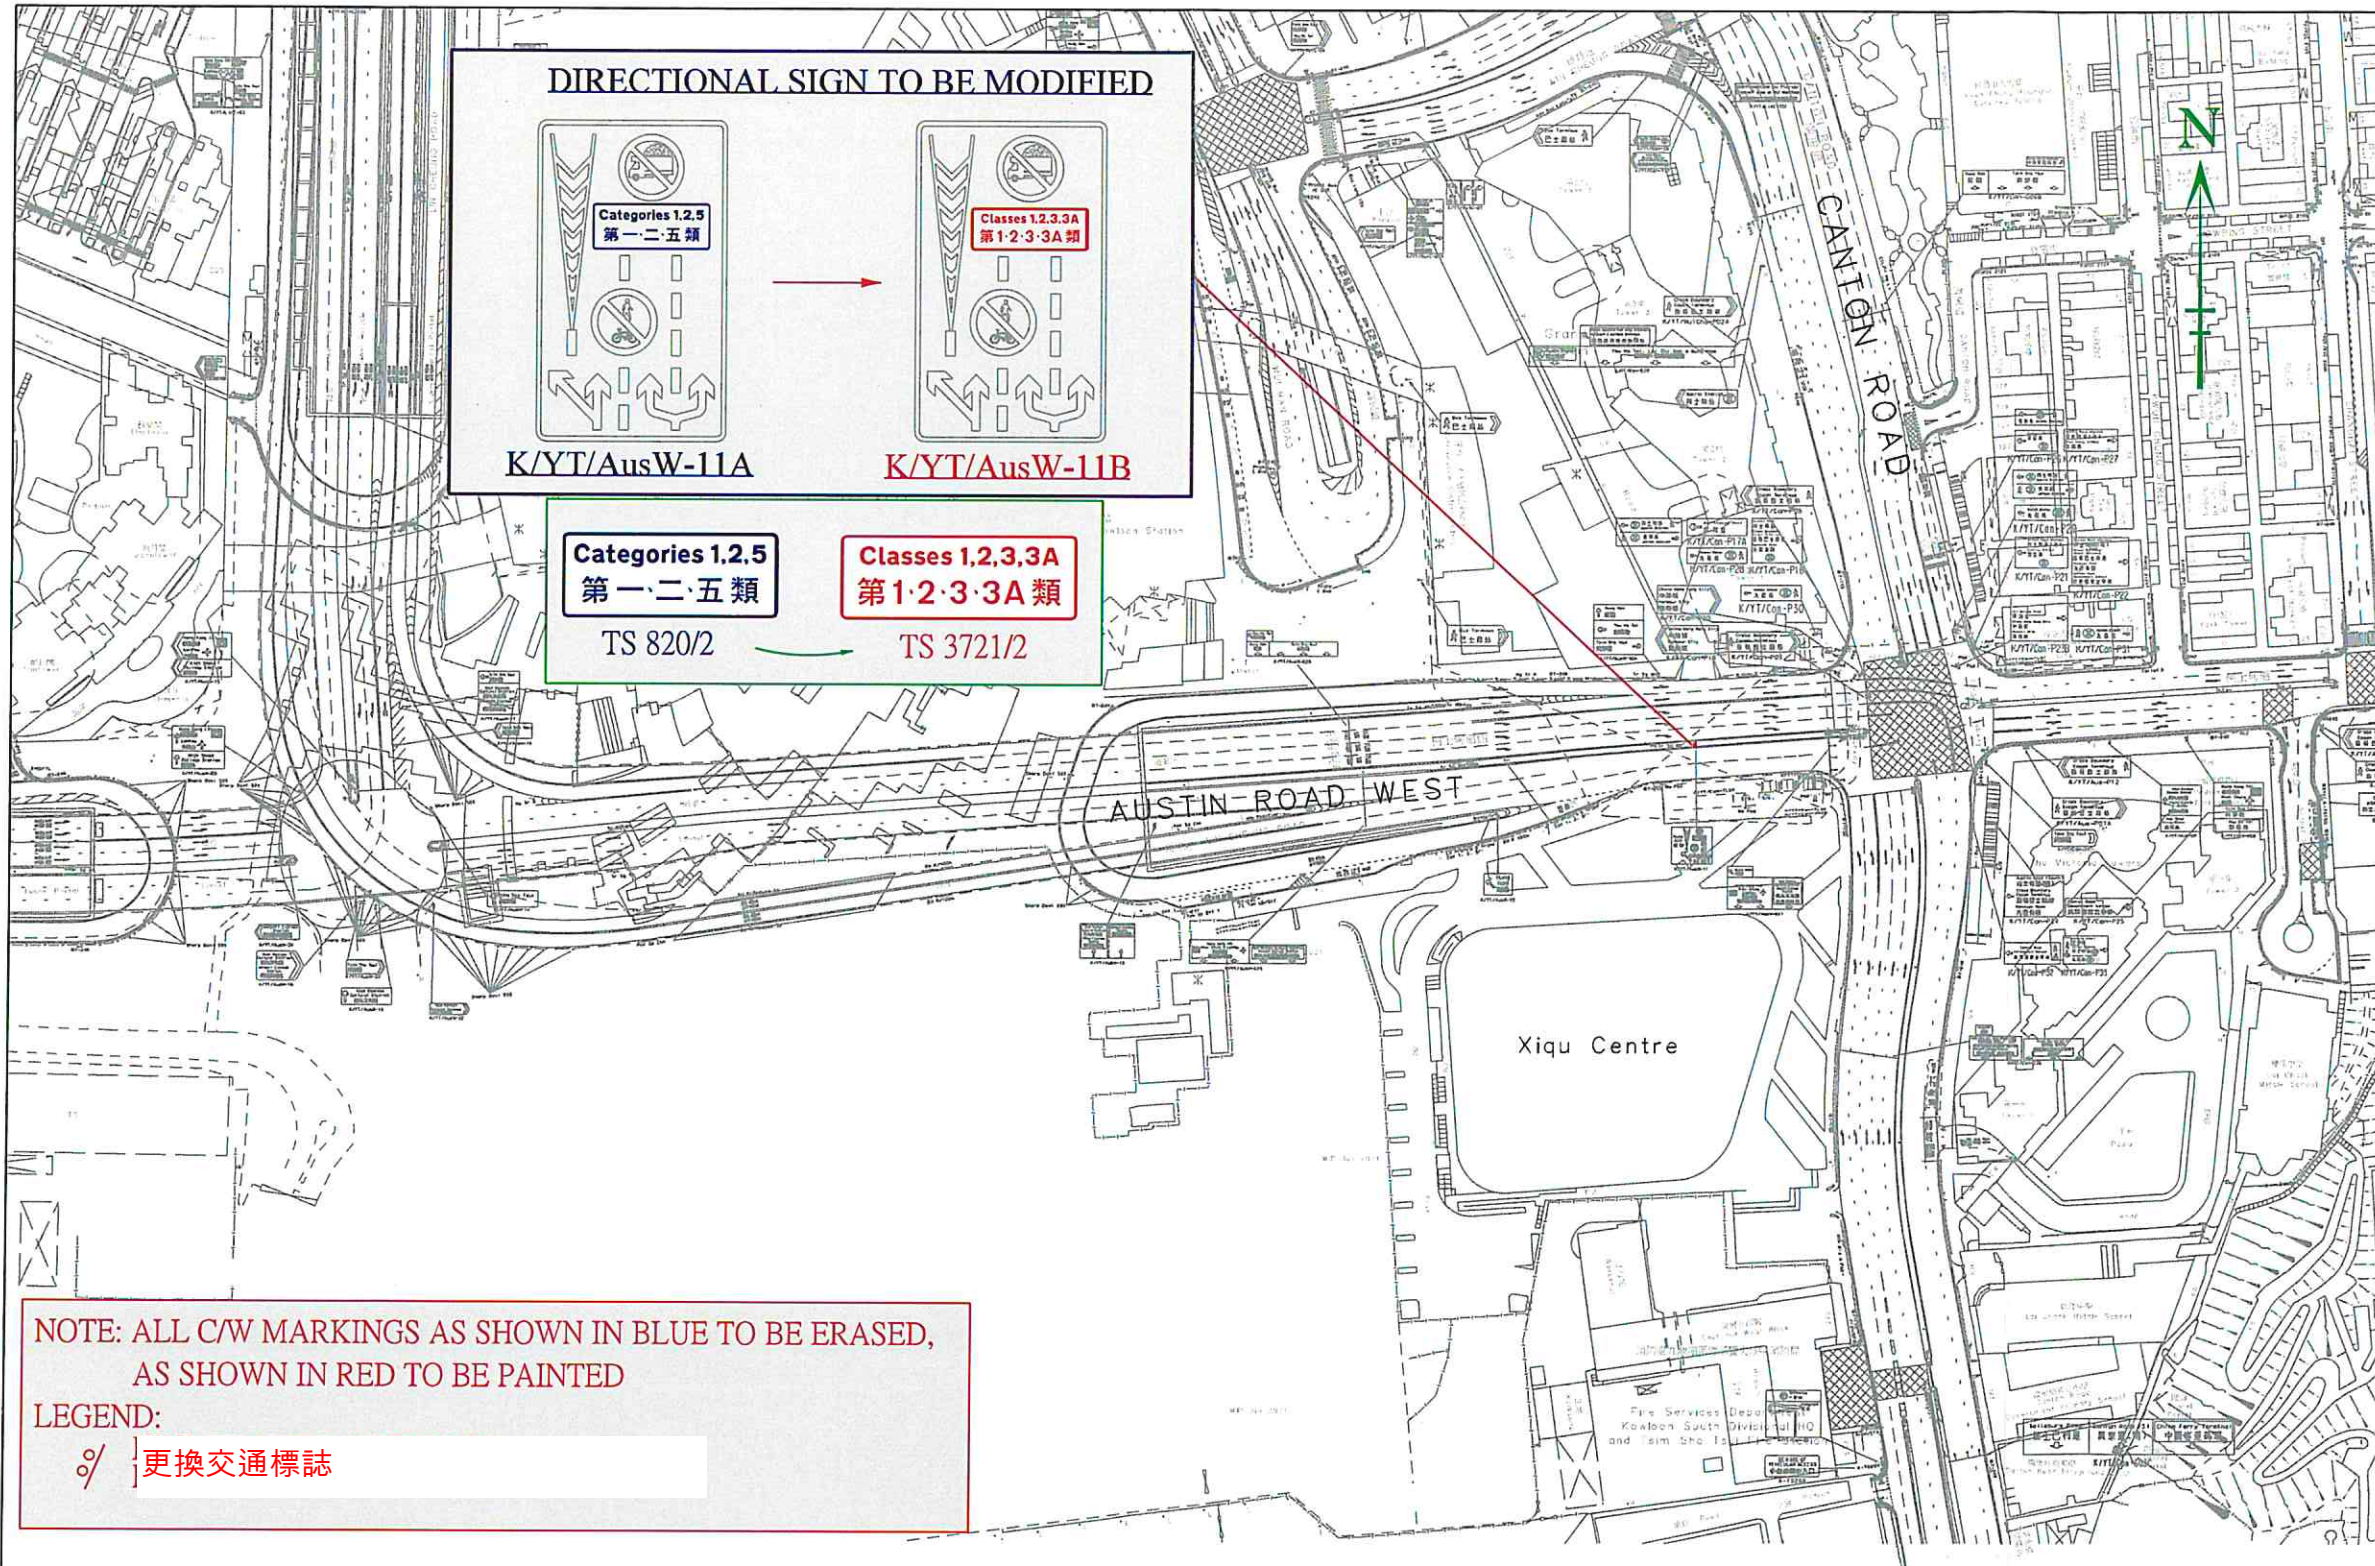

NOTE: ALL C/W MARKINGS AS SHOWN IN BLUE TO BE ERASED,
AS SHOWN IN RED TO BE PAINTED

LEGEND:
 / 更換交通標誌

<p>運輸署 Transport Department</p>	<p>TRAFFIC ENGINEERING (KLN.) DIV.</p>	<p>Location: Austin Road West near Xiqu Centre Survey Sheet No. K11P24C</p>	<p>Scale: 1:2000 (A3) Drawing No. K220498.01</p>	<p>WRF NO. WR/HY/TE/KL/22/01142 Date: 21-06-2022</p>
-------------------------------------	--	---	--	--